E-163


*Samuel E. Norris, P.E., P.S.*
Professional Engineer & Surveyor
~~285 Valley Hi Drive~~
LEXINGTON, OHIO 44904
(419) 884-~~3215~~ 0439


JOB WRIGHT SURVEY
SHEET NO. 1 OF 1
CALCULATED BY SEN DATE 11-19-92
CHECKED BY _____ DATE _____
SCALE 1" = 200'

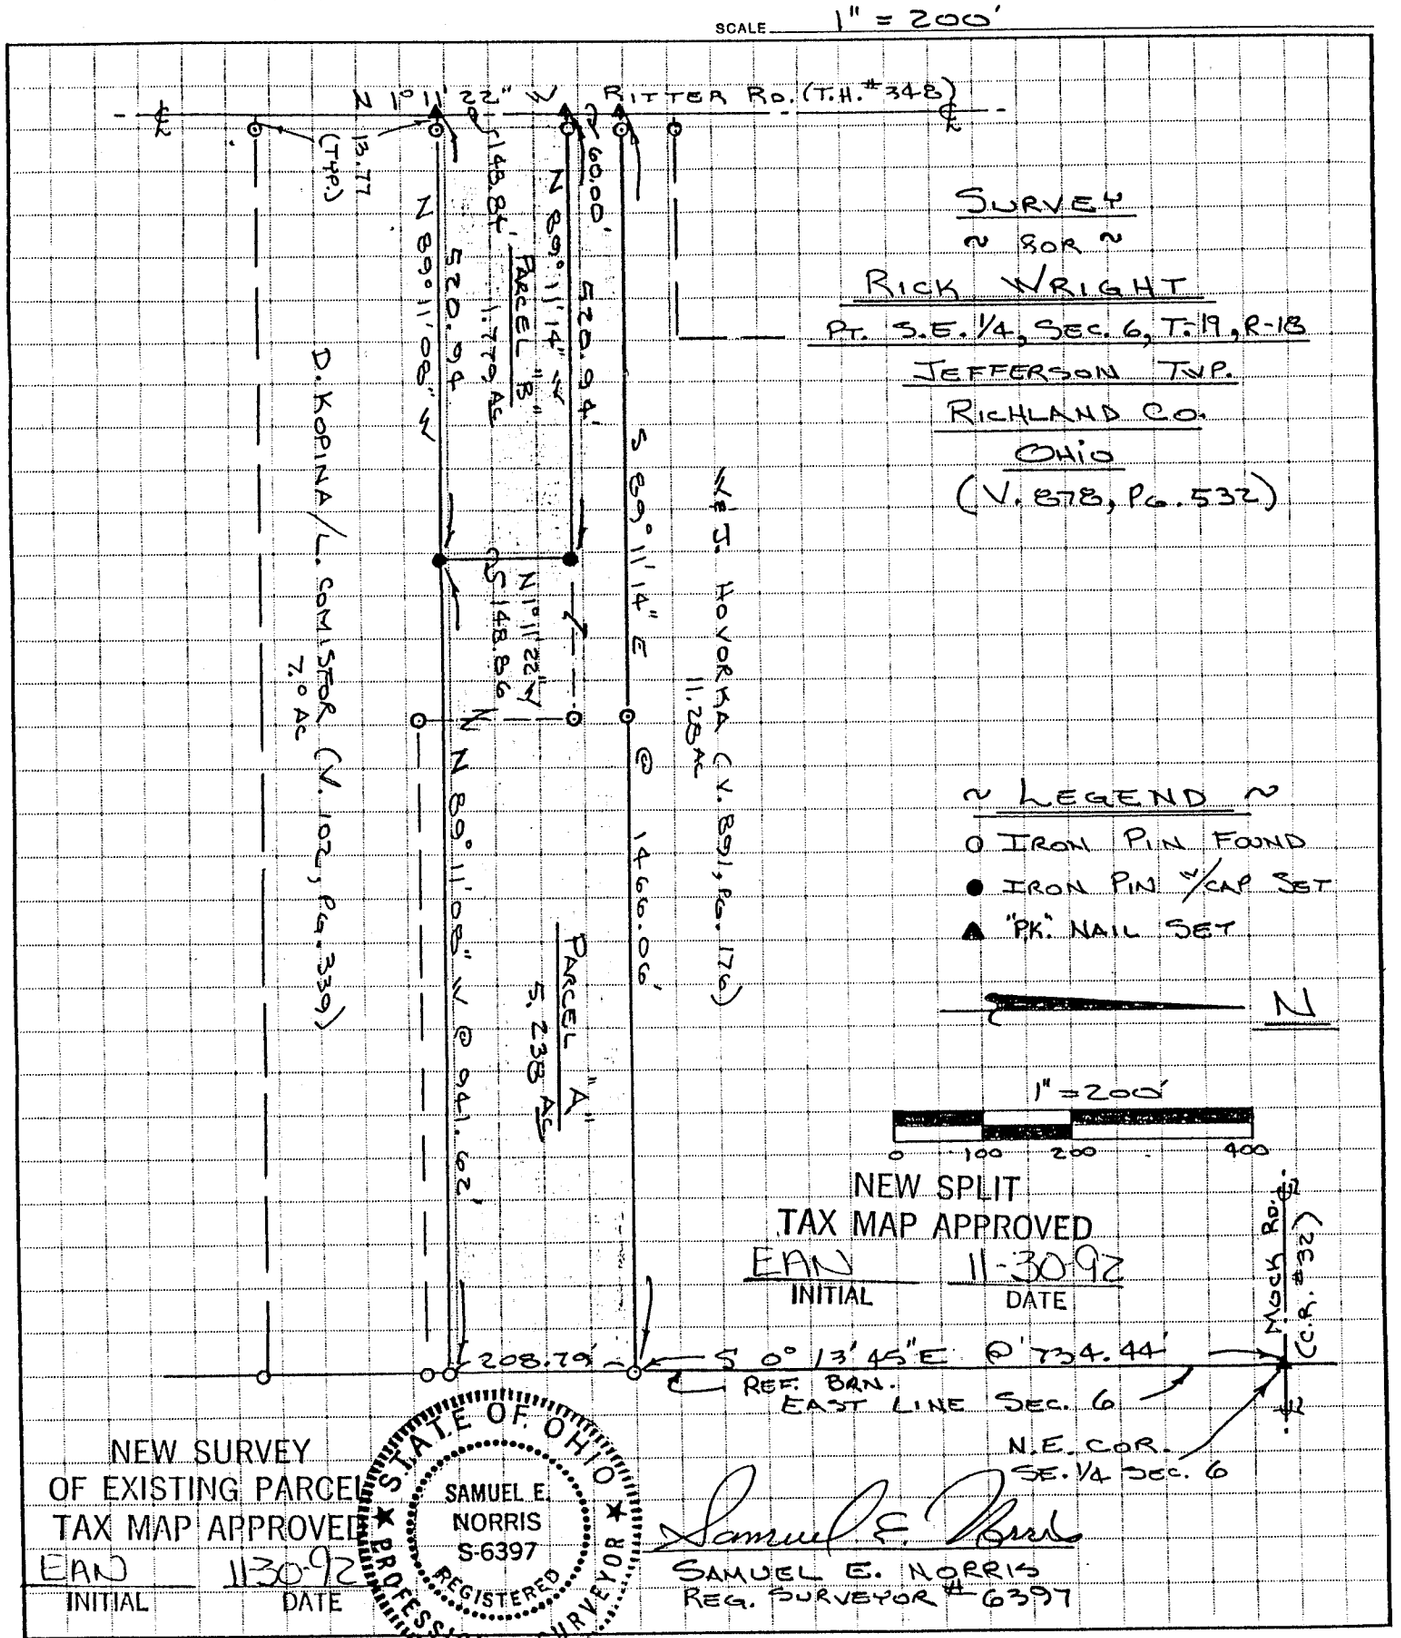


## SURVEY
~ FOR ~
## RICK WRIGHT
PT. S.E. 1/4, SEC. 6, T. 19, R-18
JEFFERSON TWP.
RICHLAND CO.
OHIO
(V. 878, PG. 532)

~ LEGEND ~
- O IRON PIN FOUND
- ● IRON PIN W/CAP SET
- ▲ "PK" NAIL SET

N

1" = 200'
0 100 200 400

NEW SPLIT
TAX MAP APPROVED
EAN 11-30-92
INITIAL DATE

NEW SURVEY
OF EXISTING PARCEL
TAX MAP APPROVED
EAN 11-30-92
INITIAL DATE

STATE OF OHIO
SAMUEL E. NORRIS
S-6397
REGISTERED
PROFESSIONAL SURVEYOR

Samuel E. Norris
SAMUEL E. NORRIS
REG. SURVEYOR # 6397


PRODUCT 204-1 NEBS Inc., Groton, Mass. 01471.


E-163